


INSTALLED 1/90

TOWN OF GROTON  
AS-BUILT DIAGRAM  
SEWER INSTALLATION

Location 340 Goldstar Hwy.  
Owner Leo Antonino  
Contractor Leitkowski Const.

See highlighted area on attachment for location.

REAR YARD.

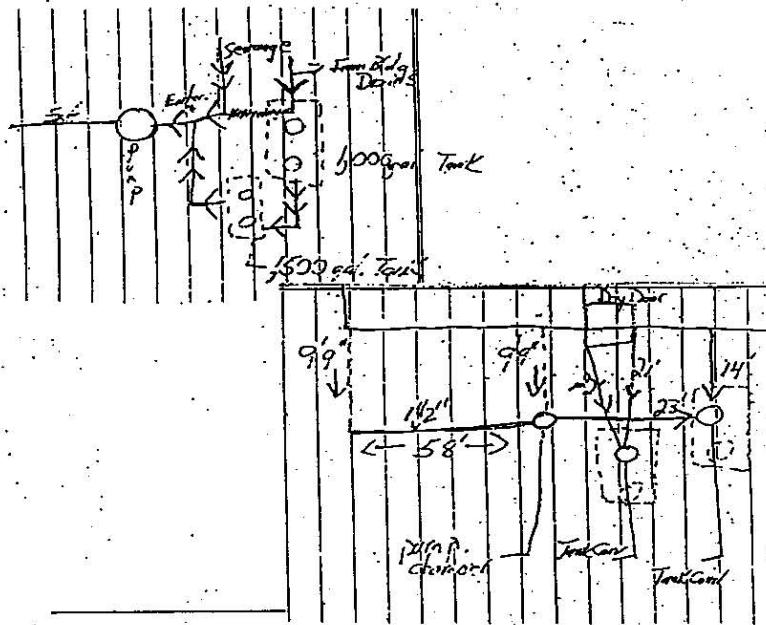

PLUMB CONT: LEITKOWSKI CONST  
ELEC CONT: THOMPSON ELEC  
BUILDING INSP: QUINN

REVISIONS	<b>GRINDER PUMP SKETCH</b>	TOWN OF GROTON WPCD GARY CT, GROTON
	ADDRESS: 340 GOLD STAR HWY	
	GROTON CHRIS SUBARU	
DWG: ANTONINO	OWNER: LEO ANTONINO	