


PLAN
SCALE - 1" = 20'

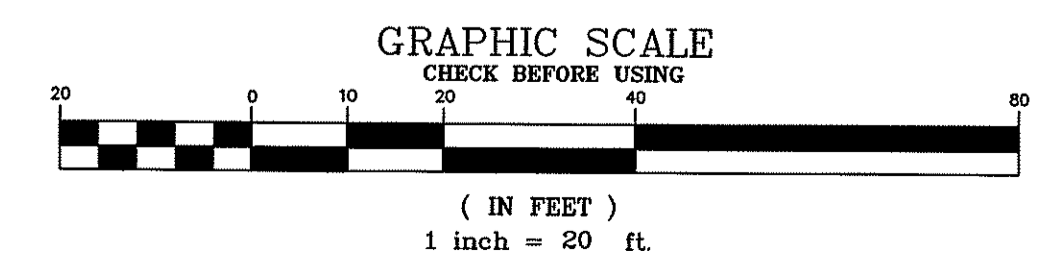

REV.	DATE	DESCRIPTION

PROJECT NO.: 00-1368
FILE NO.: fitch/dwg/fitch2-asbuilt.dwg

TOWN OF GROTON
DEPARTMENT OF PUBLIC WORKS
ENGINEERING
134 GROTON LONG POINT ROAD
GROTON, CONNECTICUT 06340
(860) 448-4666

FITCH SR. HIGH
Stormwater Outfall
Improvements
As-Built Plan

DESIGNED BY: pbg	DATE: 10-02
DRAWN BY: pbg	DATE: 10-02
CHECKED BY:	DATE:
APPROVED BY:	DATE:

SCALE: 1"=20'
DATE: October 18, 2002
PAGE NO.: 1 OF 1