

REV.	DATE	DESCRIPTION


PROJECT NO.: 02-0243  
FILE NO.: 02-0243-001

TOWN OF GROTON  
DEPARTMENT OF PUBLIC WORKS  
ENGINEERING  
134 GROTON LONG POINT ROAD  
GROTON, CONNECTICUT 06340  
(860) 448-4966


PEQUOT AVENUE  
DRAINAGE IMPROVEMENTS  
As-Built Drawings  
Plan & Profile 1

DESIGNED BY: pbg	DATE: 05-05	CHECKED BY: pbg	DATE: 05-05
DRAWN BY: pbg	DATE: 05-05	APPROVED BY:	DATE:

SCALE: As Shown  
DATE: May 10, 2005  
PAGE NO.: 1 of 2

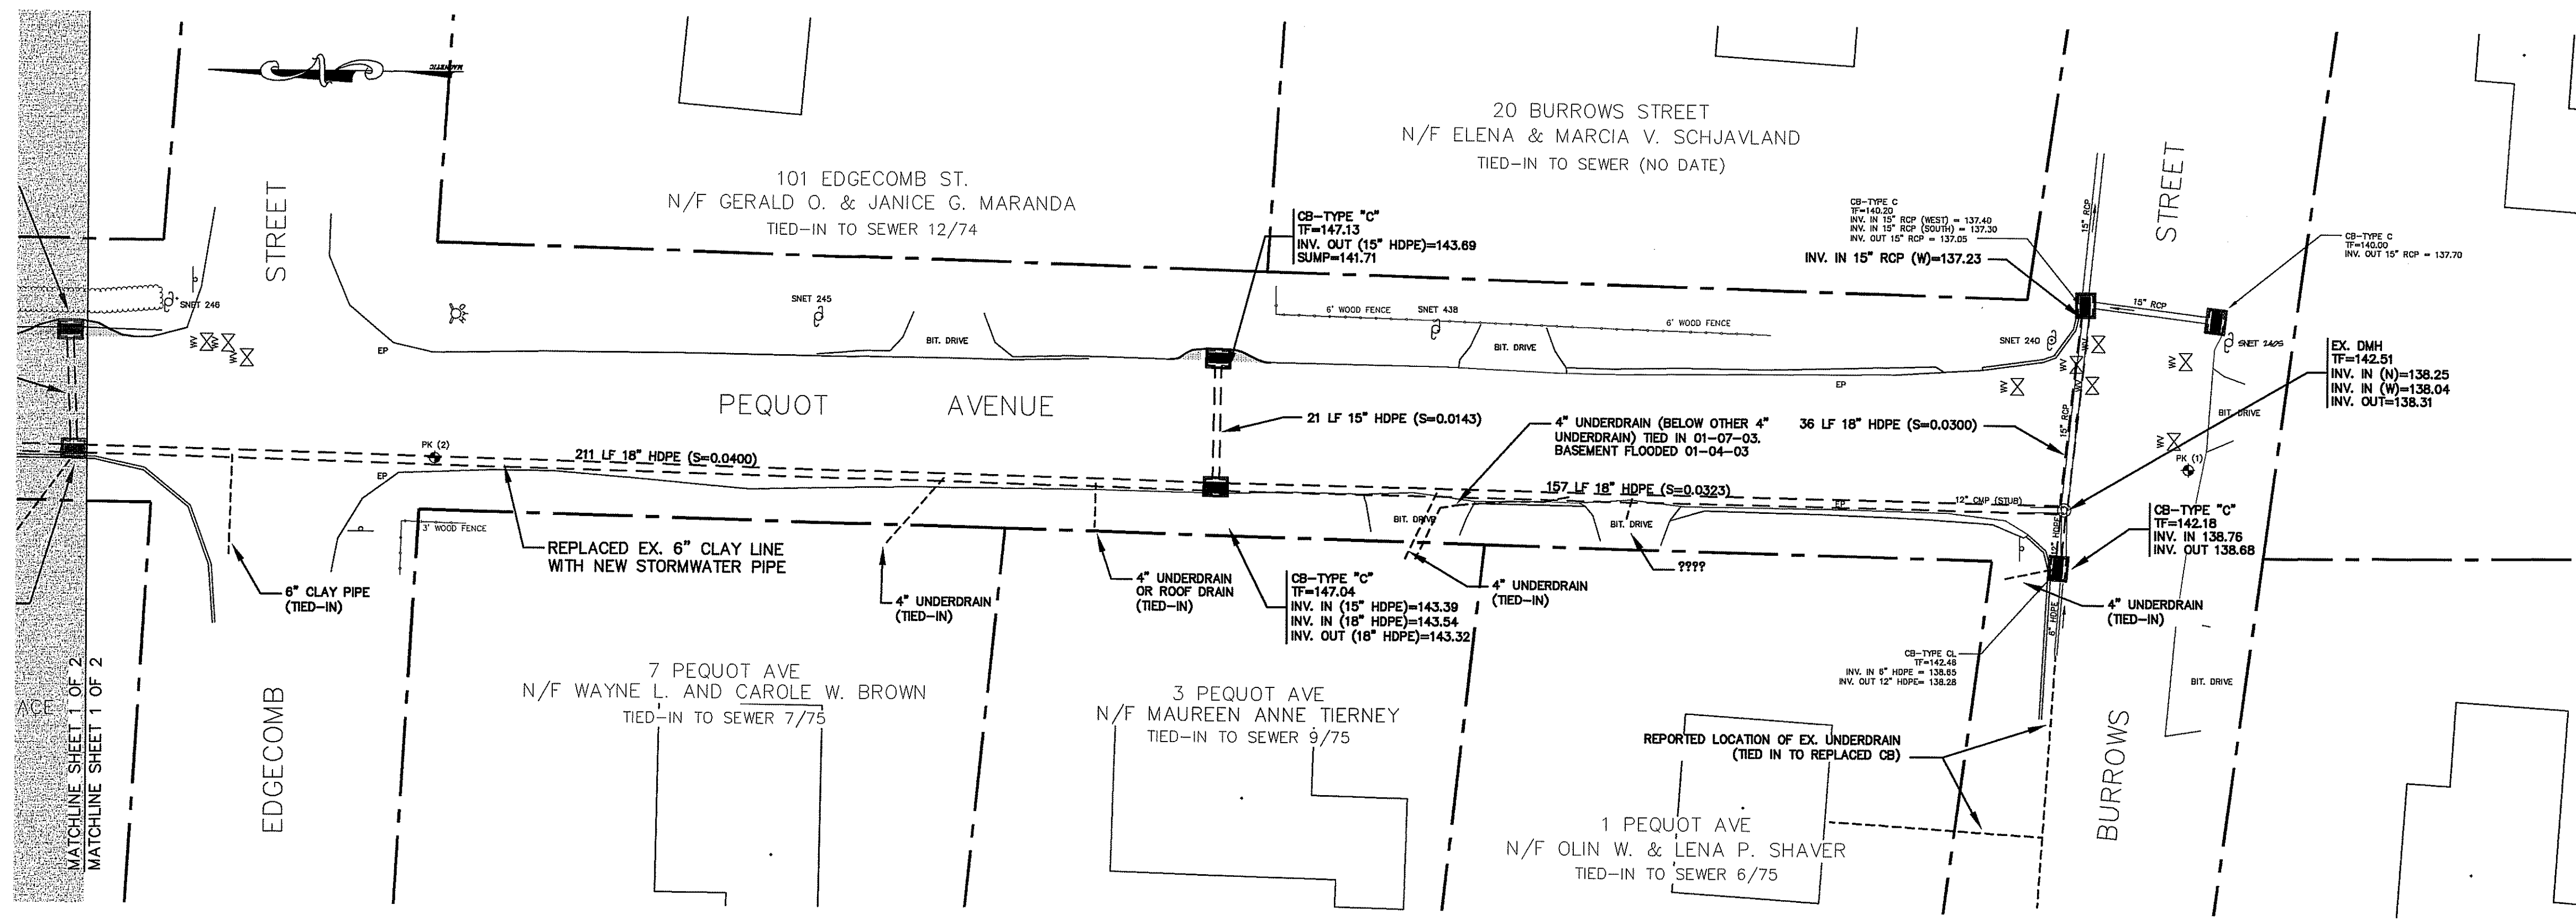

PLAN  
SCALE: 1"=20' (CHECK BEFORE USING)

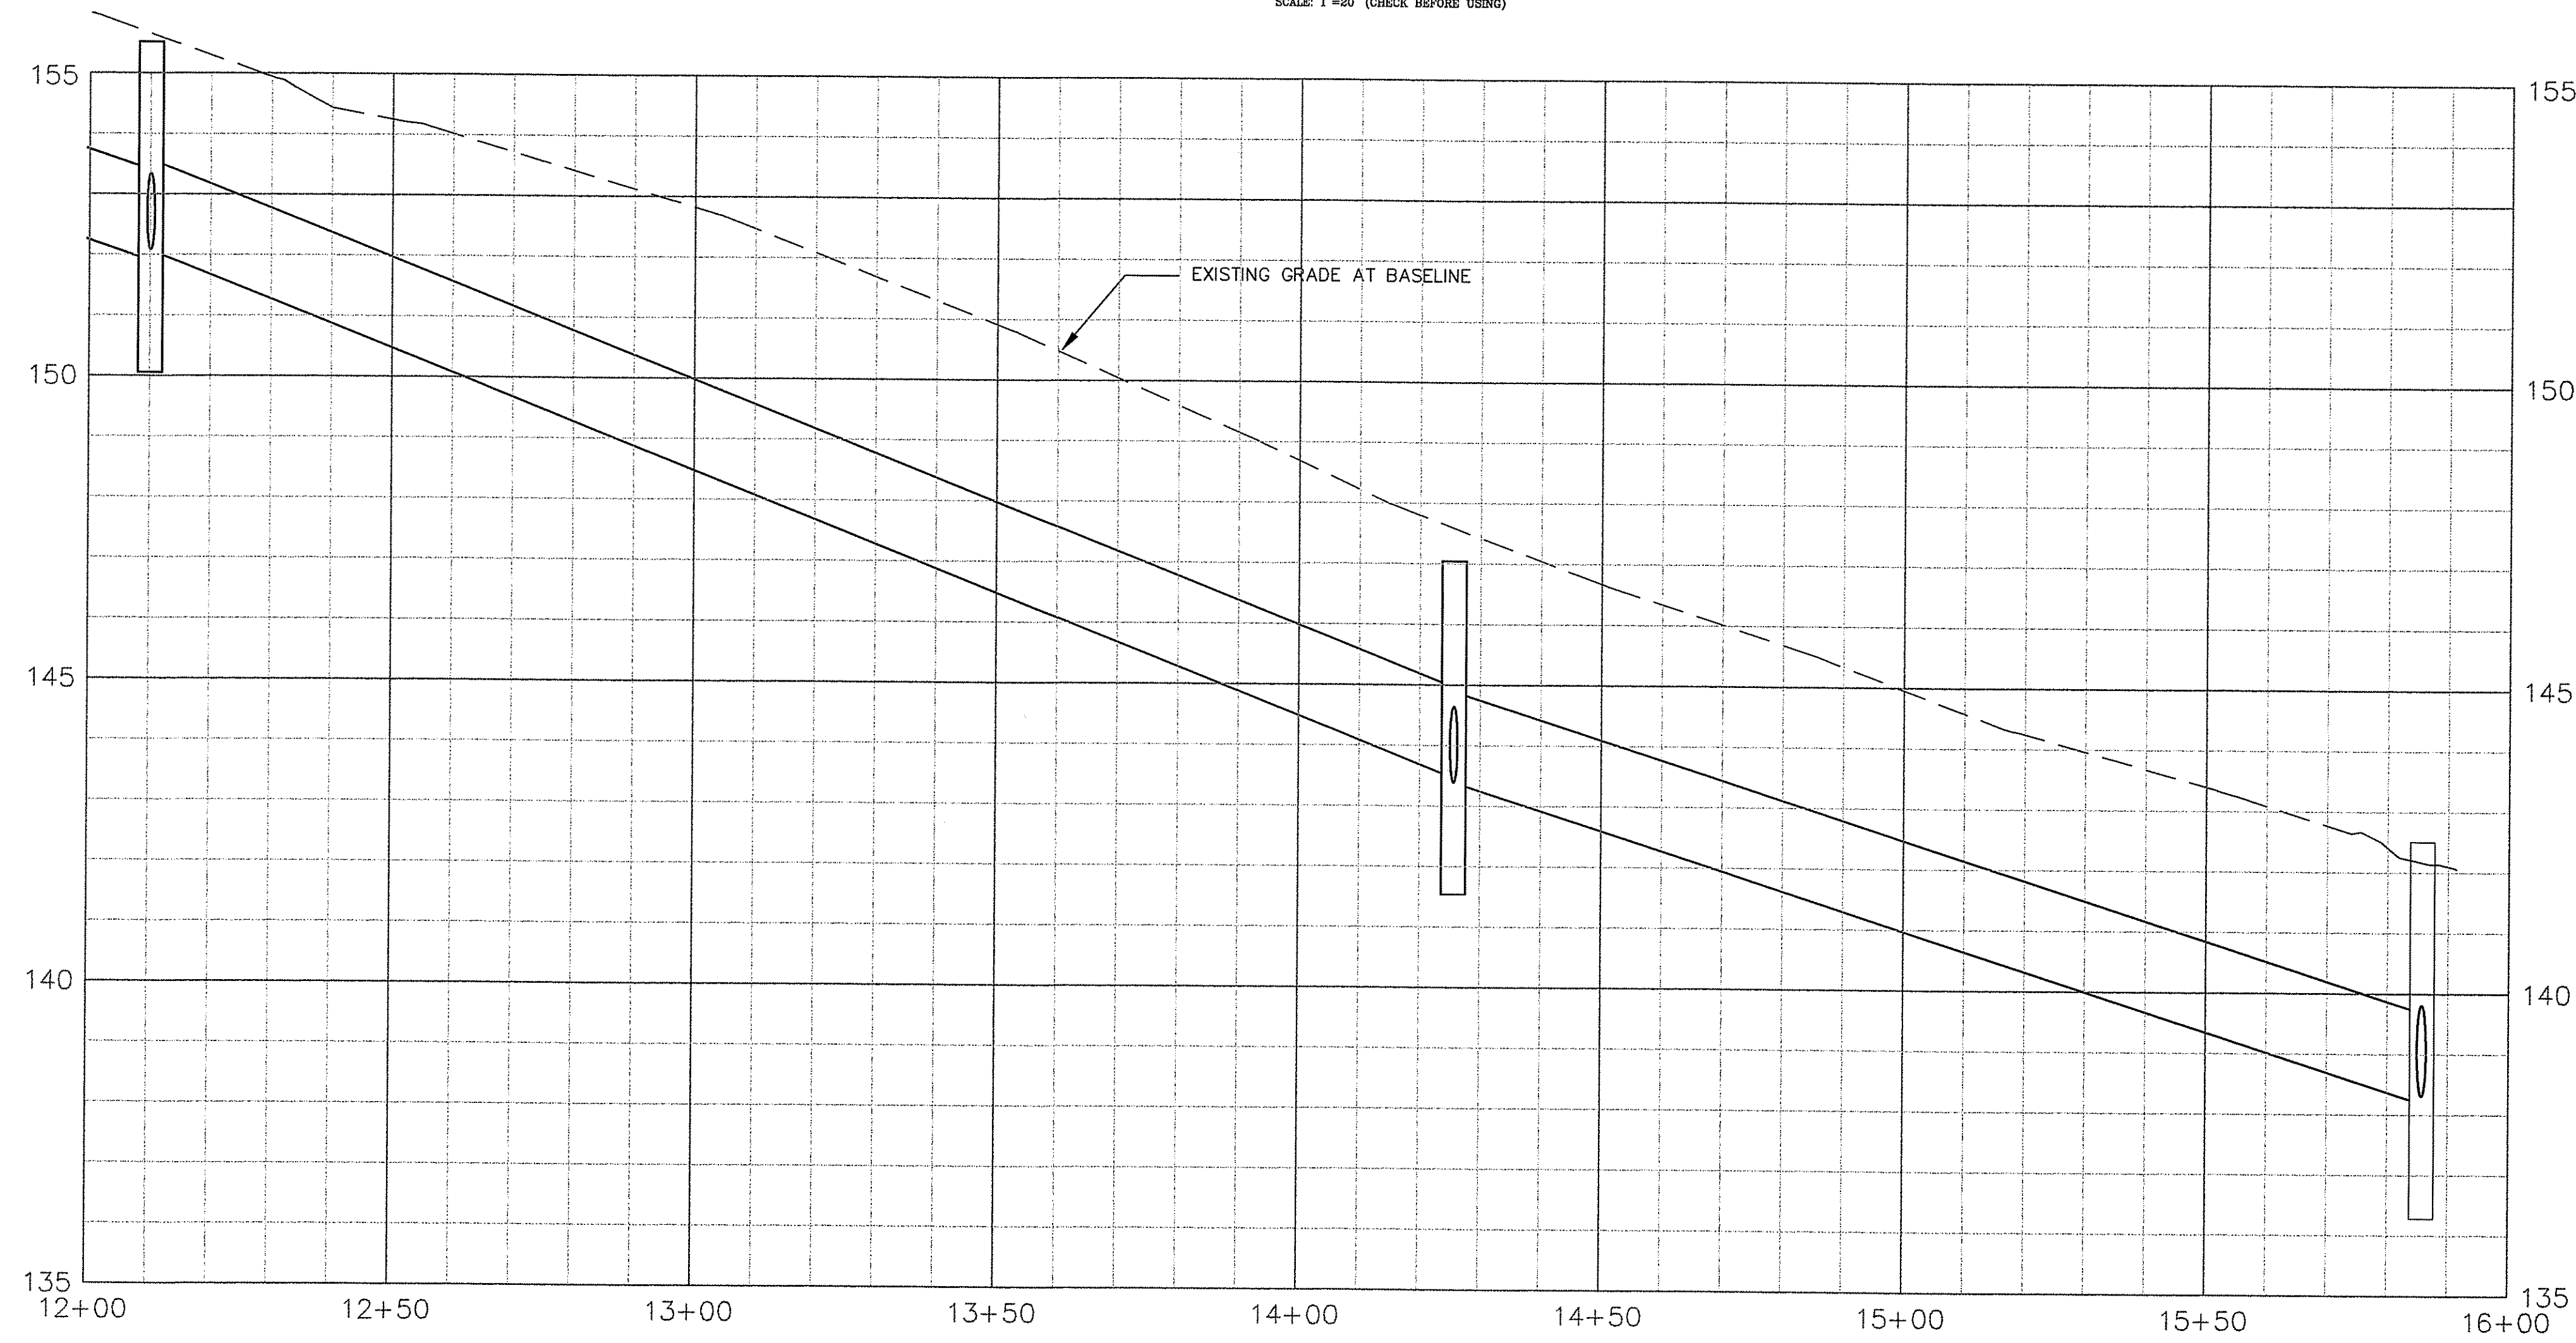

PROFILE  
SCALE: 1/4"=20' V 1"=20' (CHECK BEFORE USING)

TOWN OF GROTON	
DEPARTMENT OF PUBLIC WORKS	
ENGINEERING	
134 GROTON LONG POINT ROAD GROTON, CONNECTICUT 06340 (860) 448-4066	
PEQUOT AVENUE DRAINAGE IMPROVEMENTS	
As-Built Drawings	
Plan & Profile 2	
DESIGNED BY: pbg	DATE: 05-05
DRAWN BY: pbg	DATE: 05-05
CHECKED BY:	DATE:
APPROVED BY:	DATE:
SCALE: As Shown	
DATE: May 10, 2005	
PAGE NO.: 2 of 2	